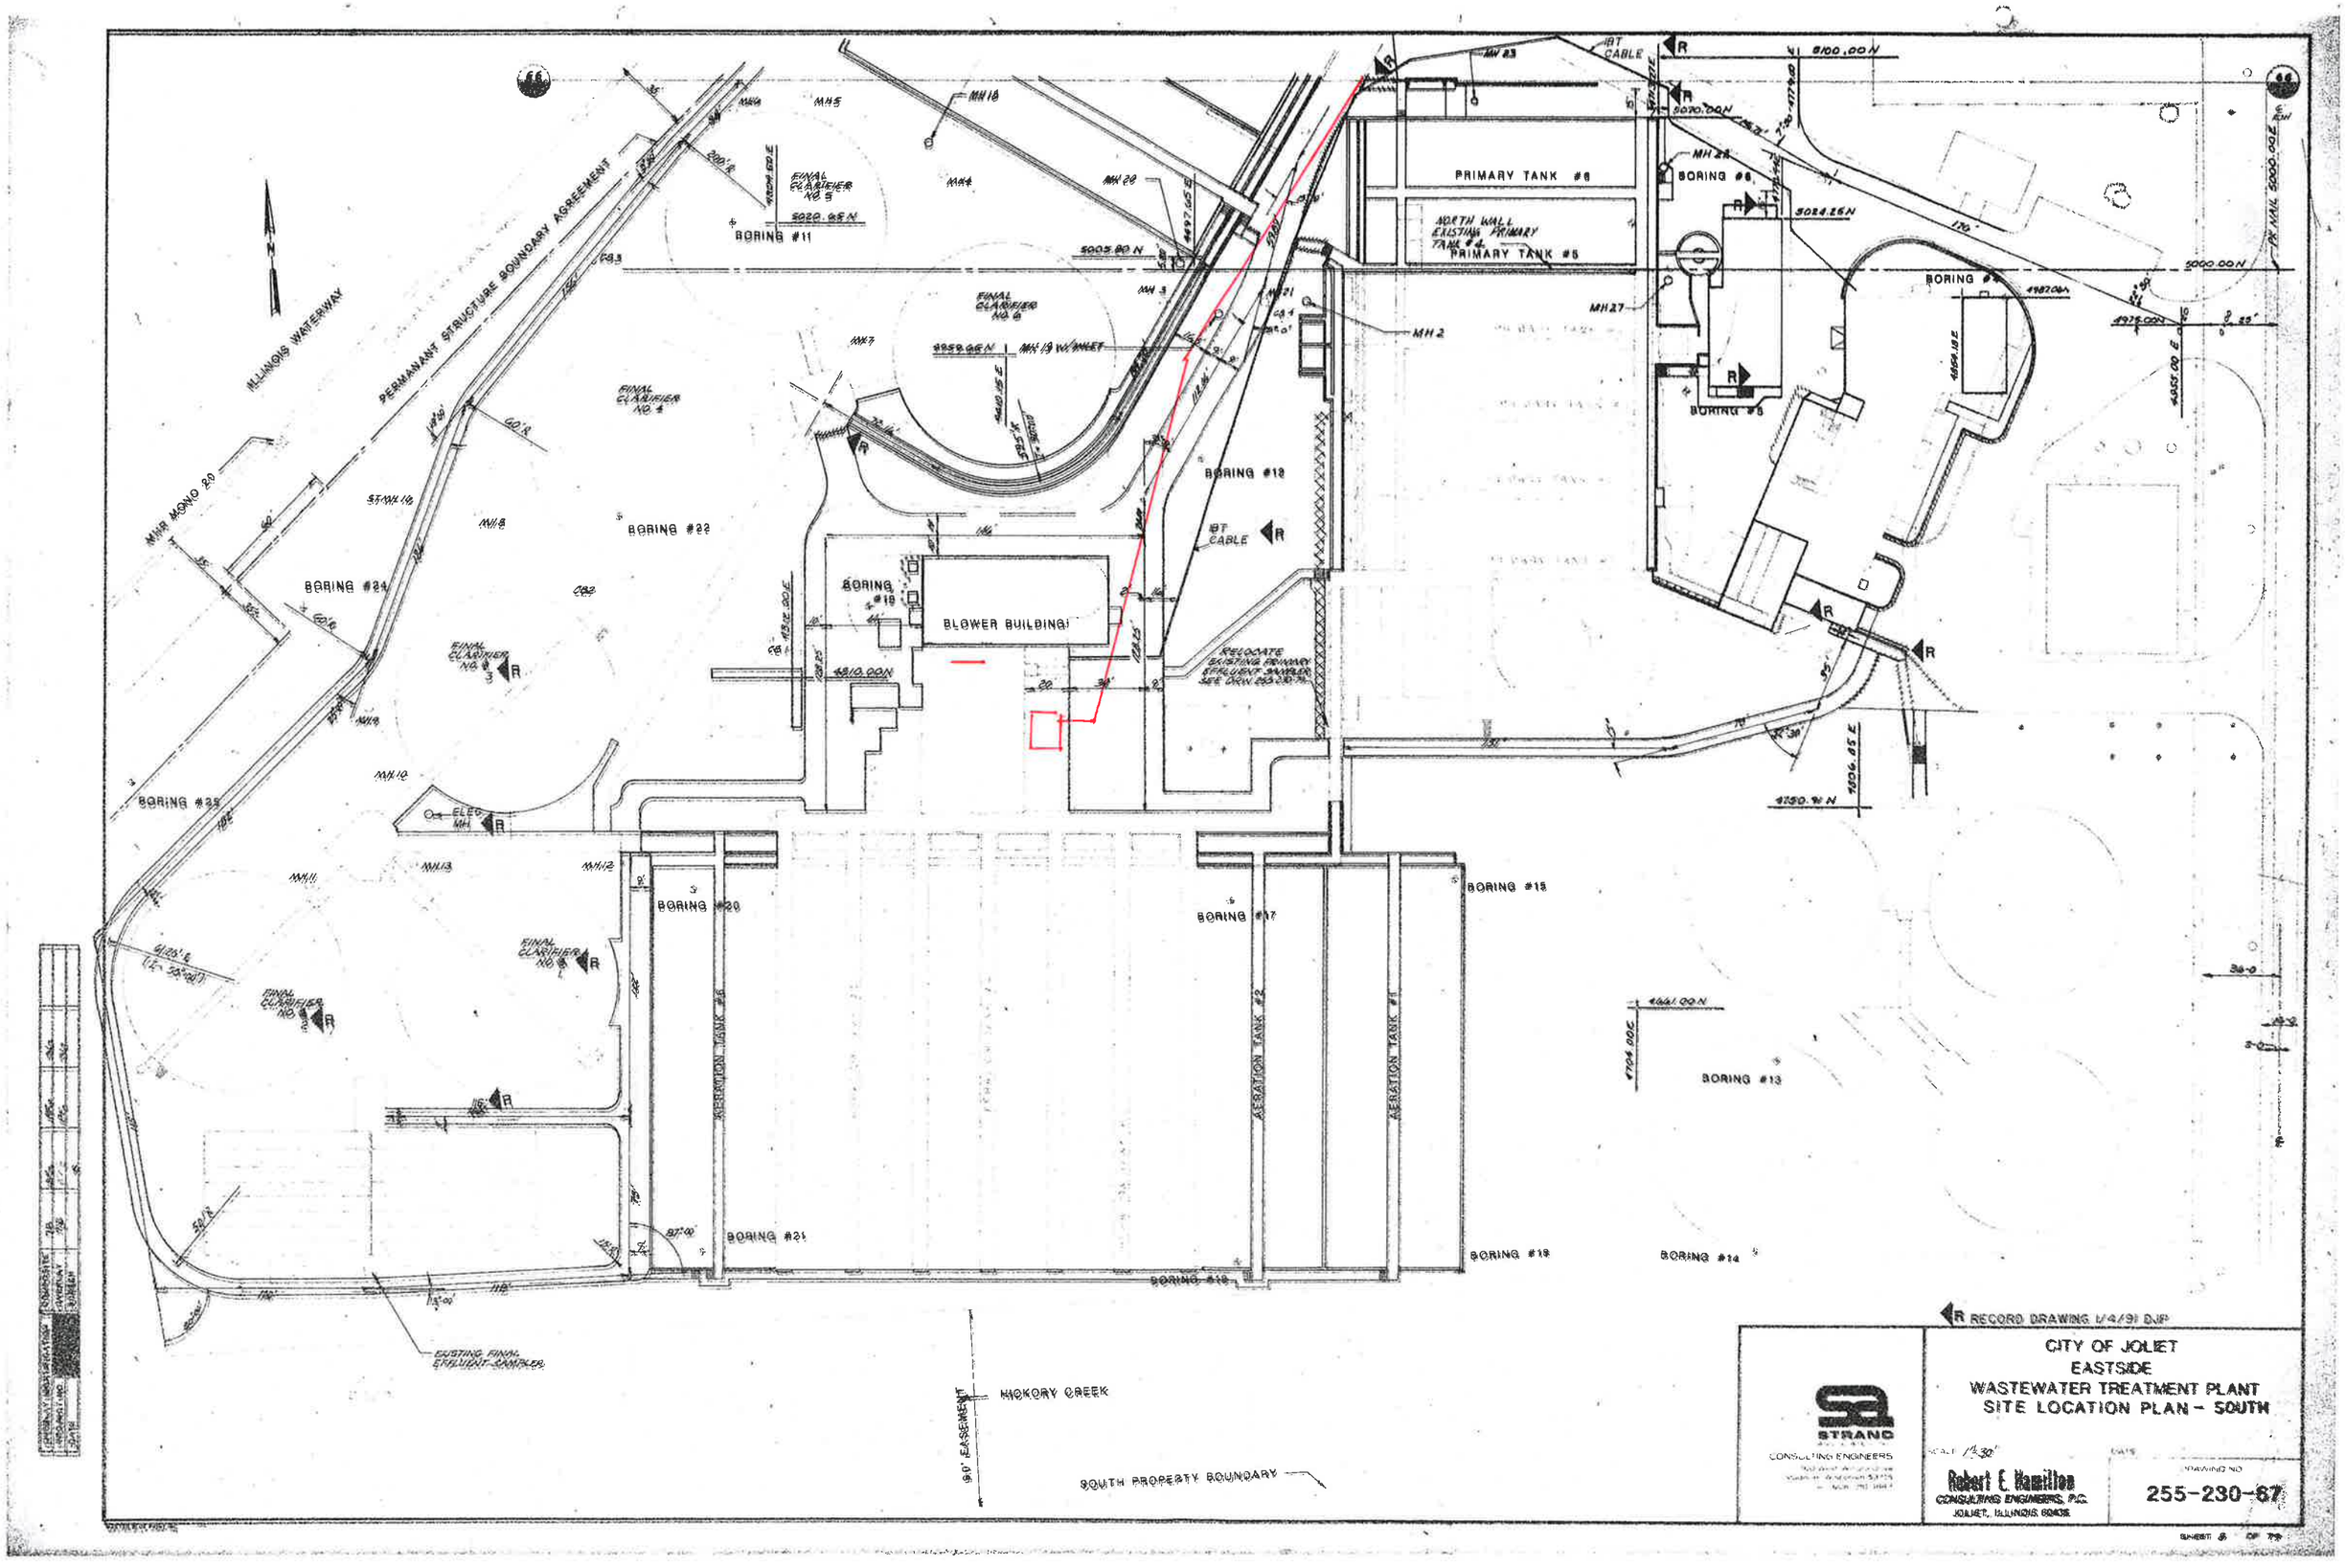

ILLINOIS WATERWAY
PERMANANT STRUCTURE BOUNDARY AGREEMENT
MHR MONO 20
FINAL CLARIFIER NO. 5
FINAL CLARIFIER NO. 6
FINAL CLARIFIER NO. 4
FINAL CLARIFIER NO. 3
FINAL CLARIFIER NO. 2
FINAL CLARIFIER NO. 1
BORING #11
BORING #22
BORING #24
BORING #25
BORING #19
BLOWER BUILDING
BORING #12
BORING #20
BORING #21
BORING #17
BORING #15
BORING #18
BORING #13
BORING #14
BORING #6
BORING #5
BORING #4
PRIMARY TANK #6
PRIMARY TANK #5
NORTH WALL EXISTING PRIMARY TANK #4
RELOCATE EXISTING PRIMARY EFFLUENT SAMPLER SEE DRW. 255-230-71
AERATION TANK #6
AERATION TANK #2
AERATION TANK #1
EXISTING FINAL EFFLUENT SAMPLER
HICKORY CREEK
SOUTH PROPERTY BOUNDARY
R RECORD DRAWING 1/4/91 DJP
STRAND
CONSULTING ENGINEERS
CITY OF JOLIET
EASTSIDE
WASTEWATER TREATMENT PLANT
SITE LOCATION PLAN - SOUTH
SCALE 1"=30'
DATE
Robert E. Hamilton
CONSULTING ENGINEERS, P.C.
JOLIET, ILLINOIS 60435
DRAWING NO.
255-230-67
SHEET 8 OF 79